


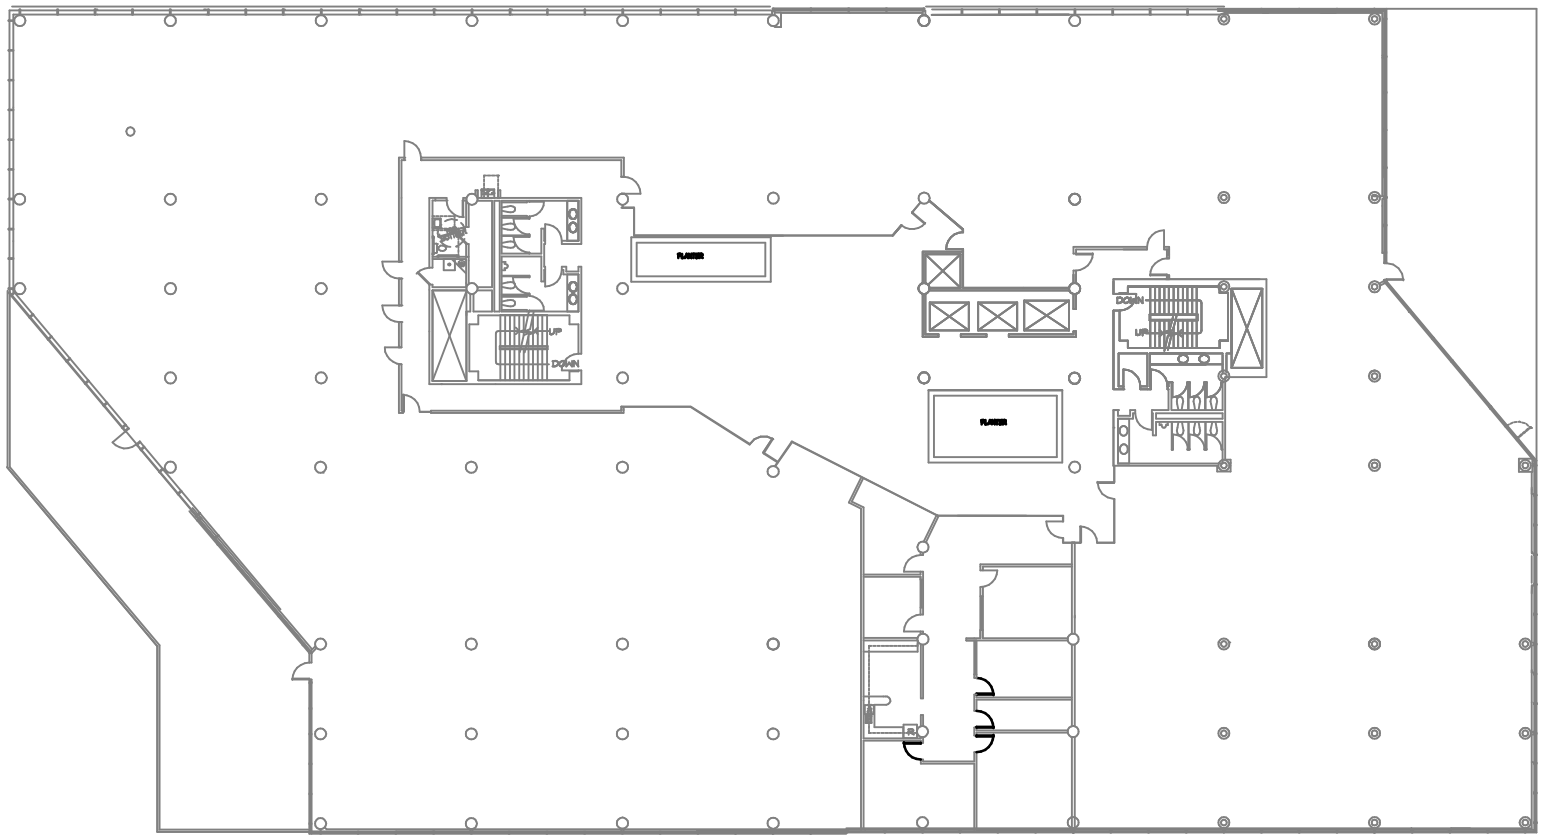

SUITE 410 - AS-BUILT
SCALE: NOT TO SCALE

