


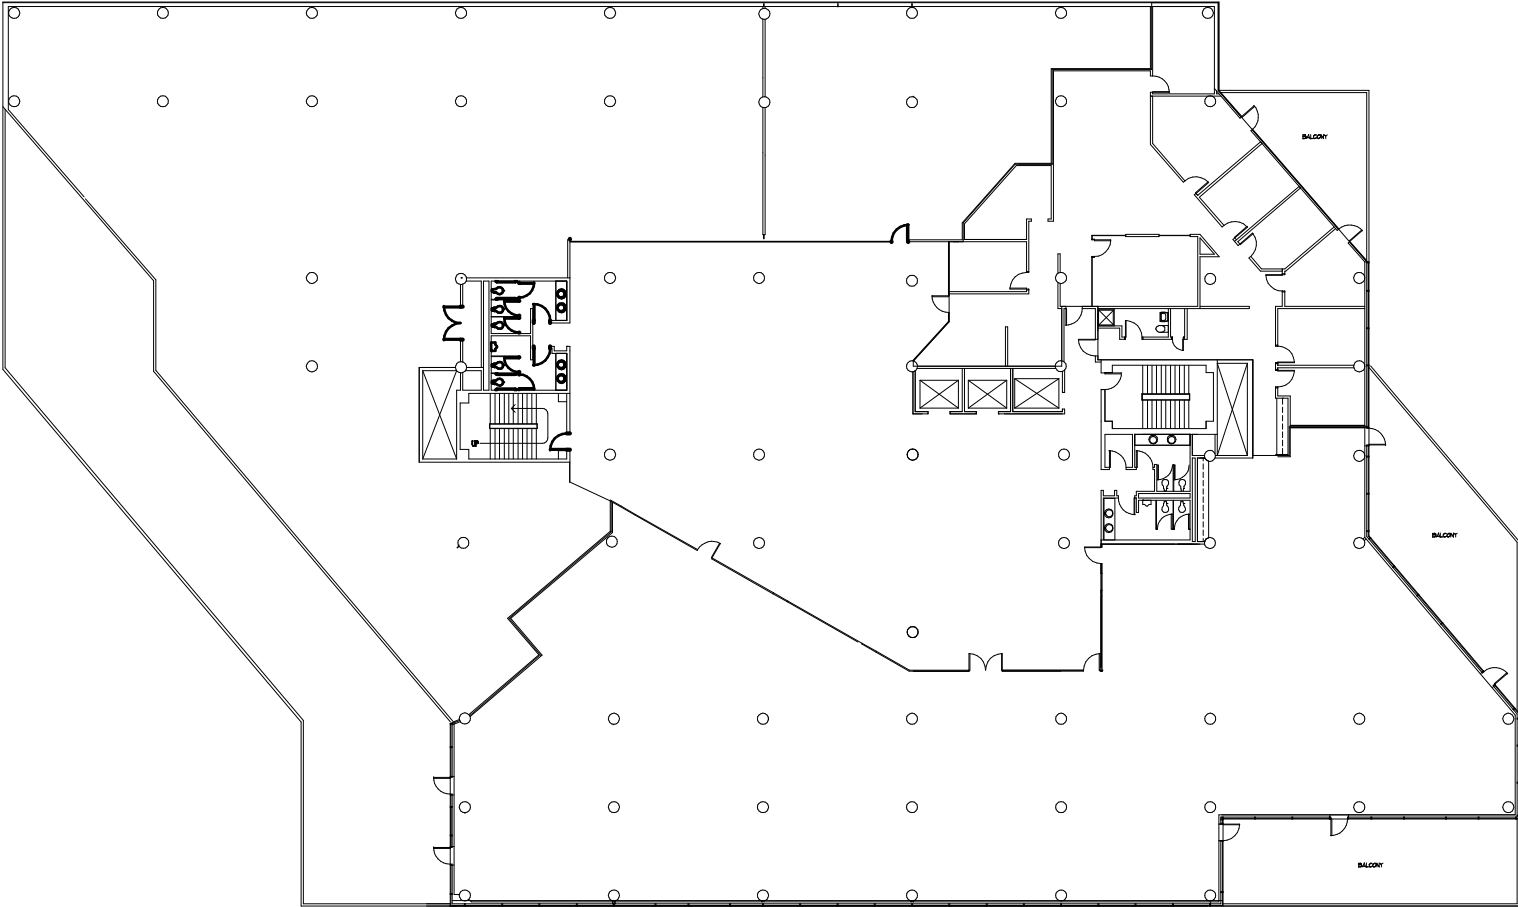

5TH FLOOR AS-BUILT
SCALE: NOT TO SCALE

