


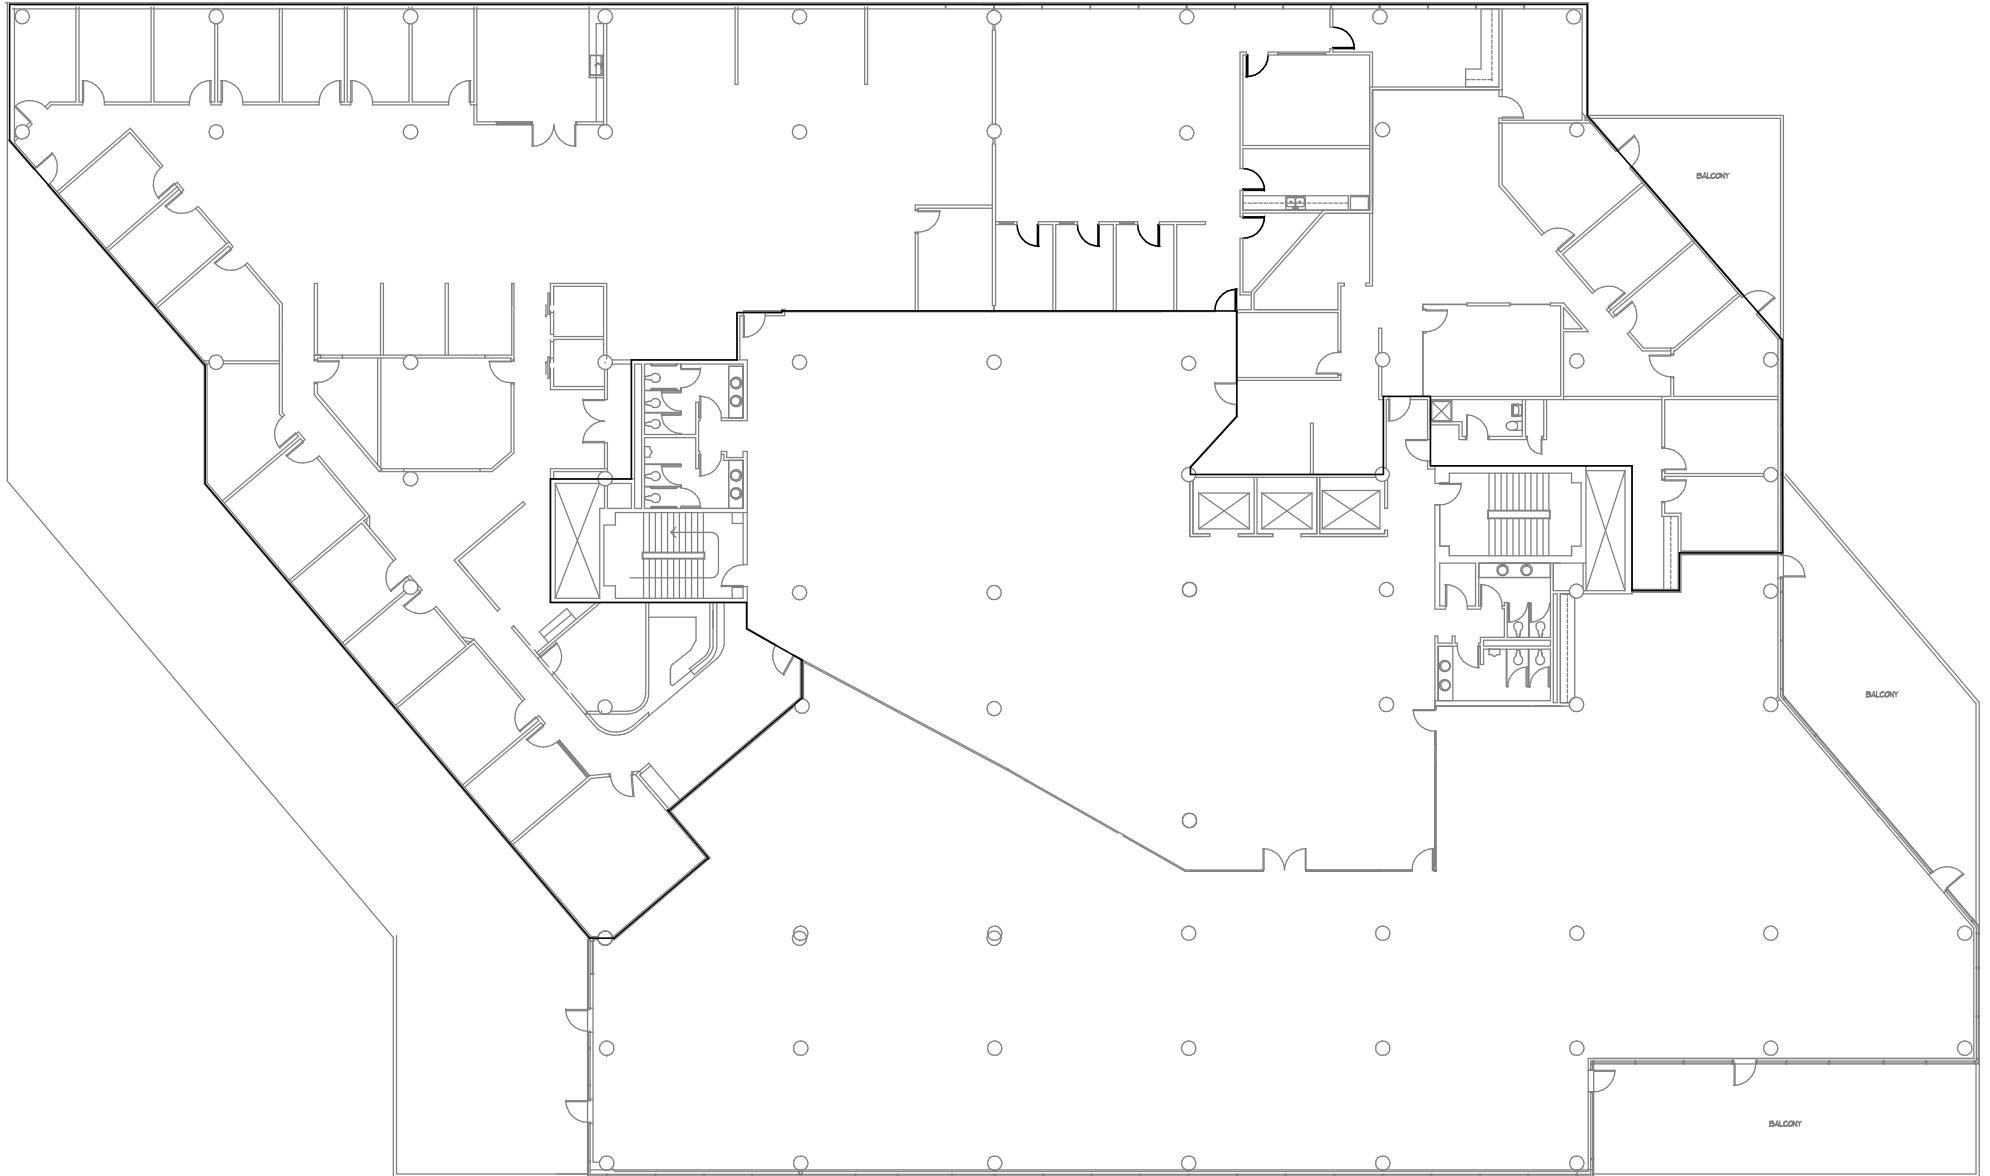

5TH FLOOR AS-BUILT

SCALE: NOT TO SCALE